

บริษัท เอ.ส.อี. คอนสตรัคชั่น (ประเทศไทย) จำกัด
J-SONS CONSTRUCTION (THAILAND) COMPANY LIMITED
183/38-37 ถนนแจ้งวัฒนะ แขวงแจ้งวัฒนะ เขตหลักสี่ กรุงเทพฯ 10310
Tel. (053) 214963 Fax. (053) 219842

ASBUILT DRAWING

vk8kigiupoc[txDb[y9bdk
8lt;bl;diI,LkI9iN
,sk;bmpk]ypg=up'.s,j

OWNER

มหาวิทยาลัยราชภัฏวไลยอลงกรณ์

ARCHITECTS

เลี่ยม อธิธาภิธานนท์ สถา. ๐2 ส.

STRUCTURAL ENGINEERS
 បុព្វប័ត្រ ក្រសួងការងារ រ.ព. 1645

SANITARY ENGINEERS
ဘဒိန္နမာလာ **ဇာတိယောဂျီဝနသိ** **၂၀၁၂. ၁၈၀၂**

ELECTRICAL ENGINEERS			
นางสาว	วราธิพร พงษ์	เลขที่	828
ภานุมาศ	ชินติ	วันที่	2010

MECHANICAL ENGINEERS
සංස්කූතික ඉංජිනේරුවන් 8137

DRAWN
ଦ୍ଵିତୀୟ

SHEET TITLE

3rd. FLOOR PLAN (TENDON LAYOUT)

SCALE :	AS SHOWN
DATE :	28 ธันวาคม 2542


APPROVED :

DATE

DRAWING NO.	TOTAL SHEET
-------------	-------------

S-10

33

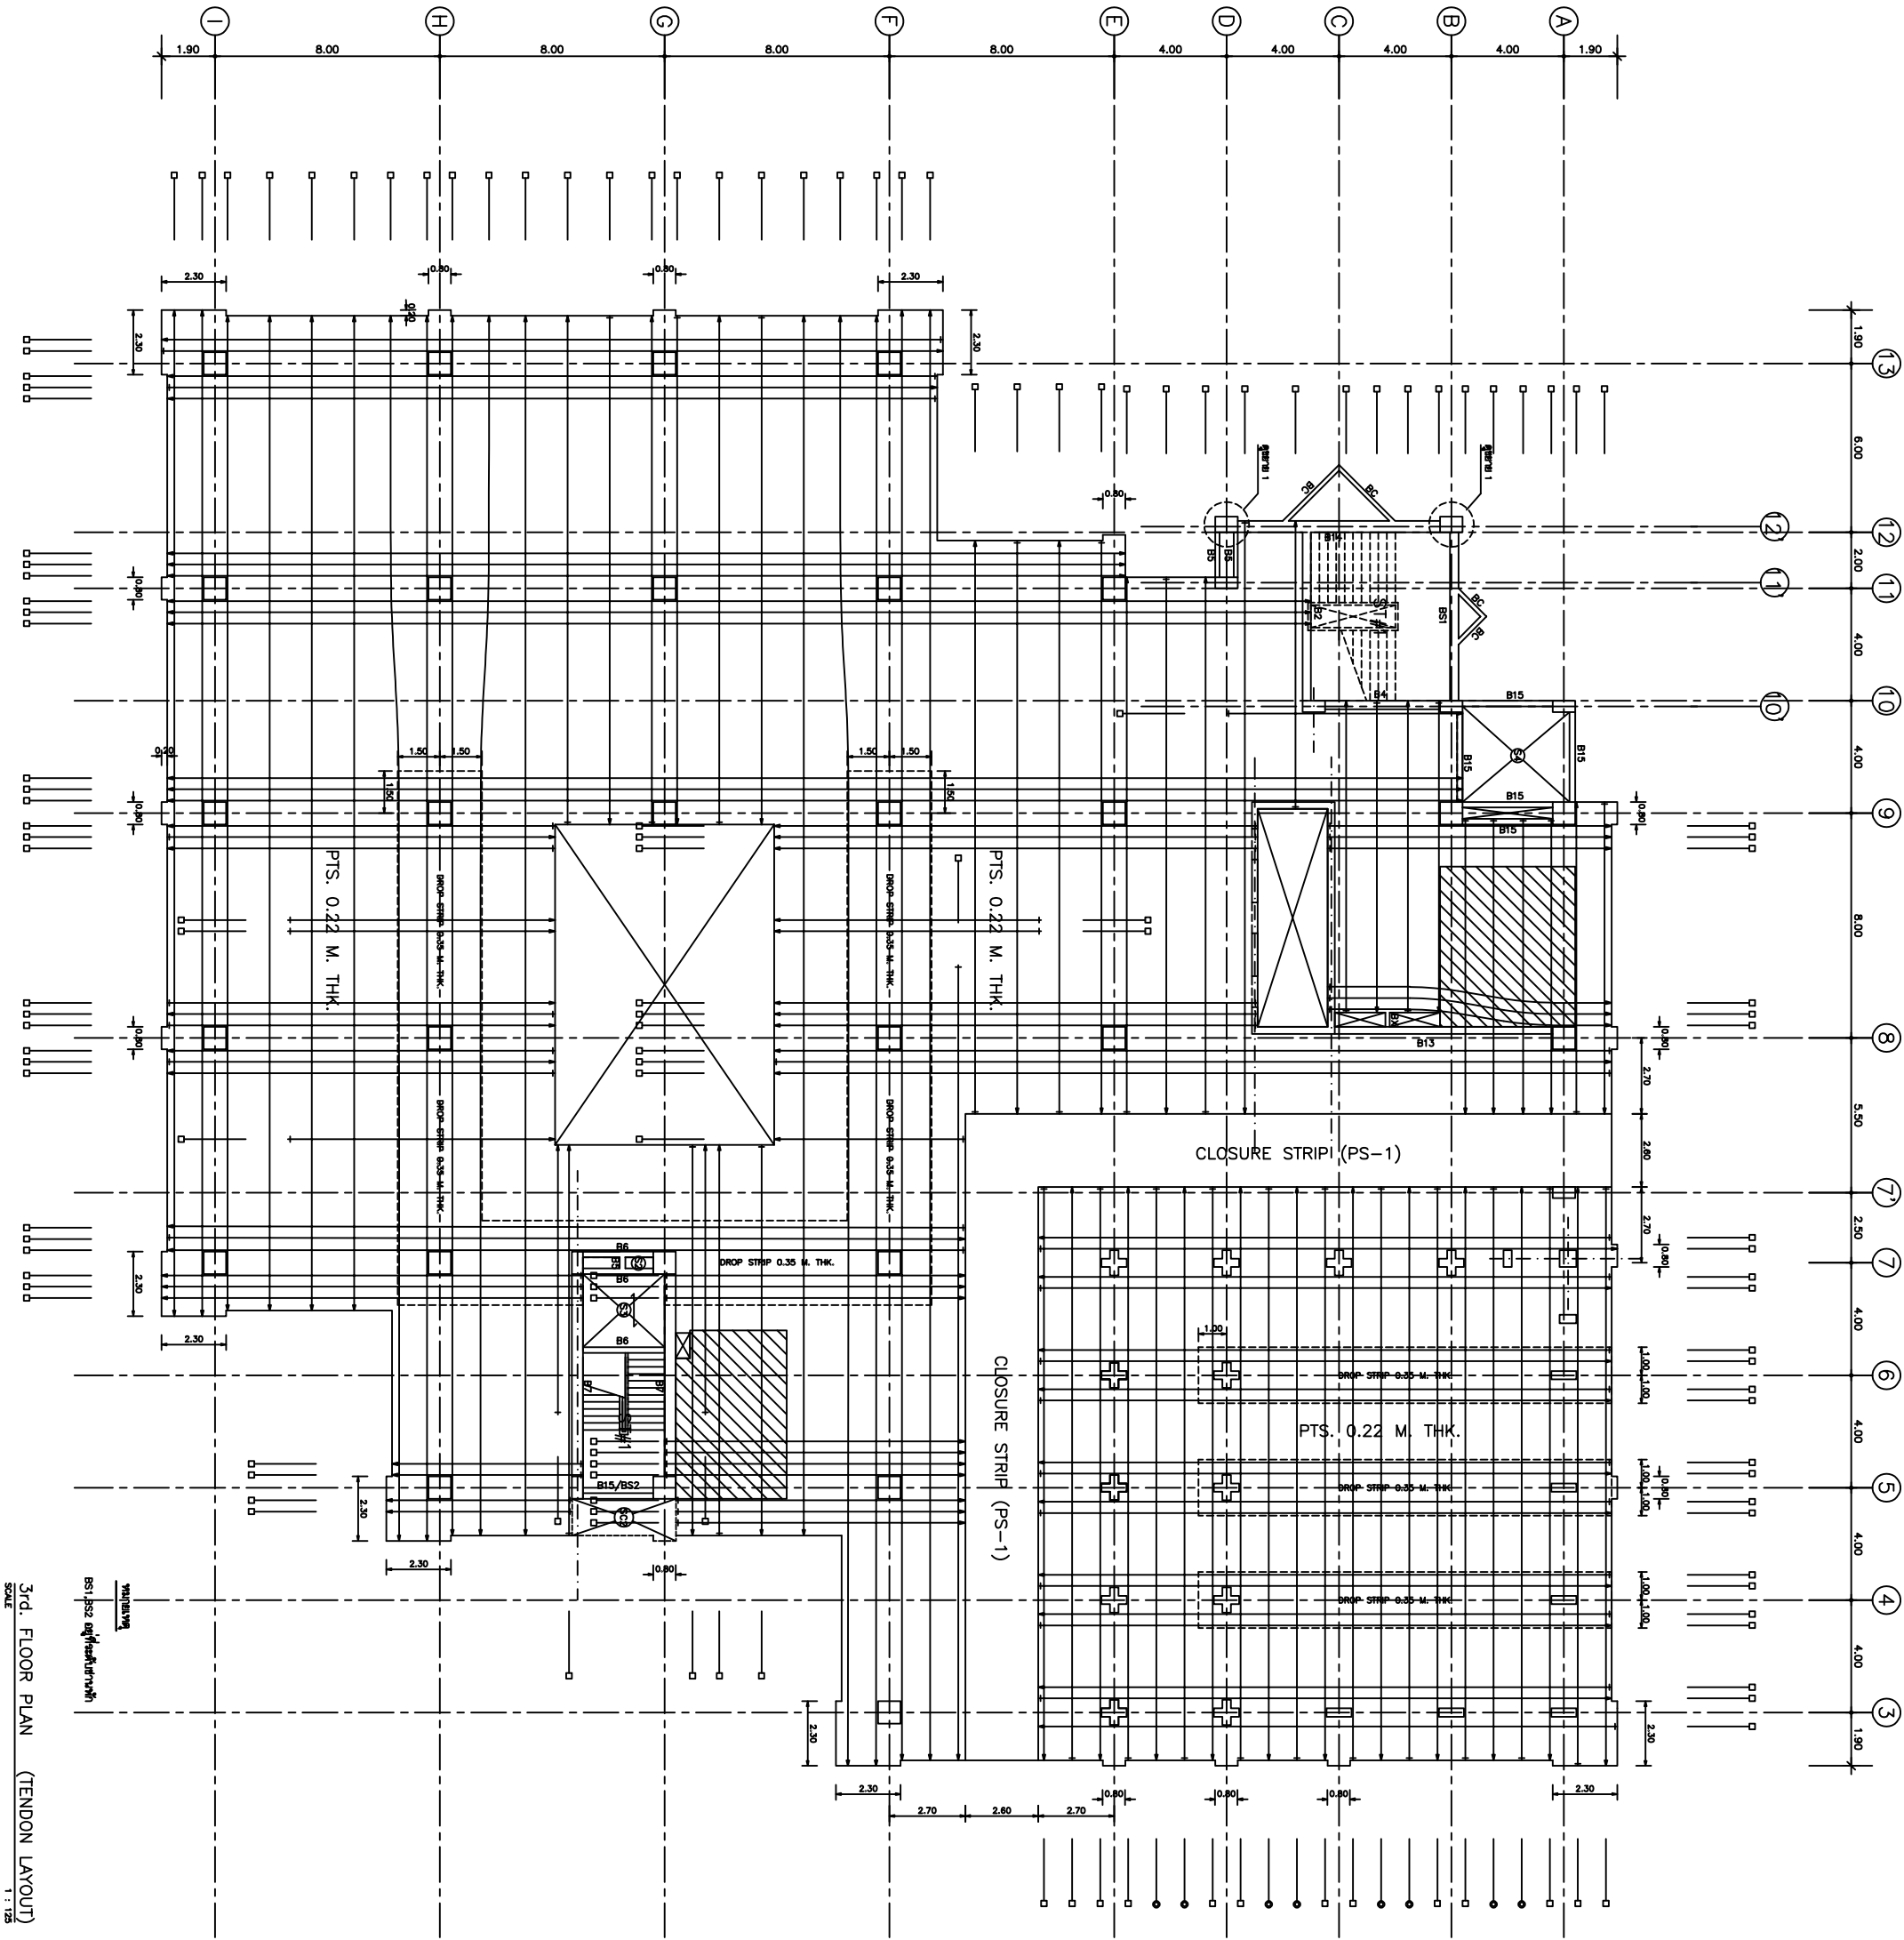


 A technical drawing of a rectangular plate. The overall width is labeled as 125 mm. The overall height is labeled as 125 mm. There is a central rectangular hole with a width of 10 mm and a height of 12 mm. The distance from the top edge of the plate to the top edge of the hole is 10 mm. The distance from the bottom edge of the plate to the bottom edge of the hole is 12 mm. The distance from the left edge of the plate to the left edge of the hole is 10 mm. The distance from the right edge of the plate to the right edge of the hole is 12 mm.

3rd. FLOOR PLAN (TENDON LAYOUT)

SCALE 1 : 125